


**Suite 705
1,148 SF
Available
For Lease**

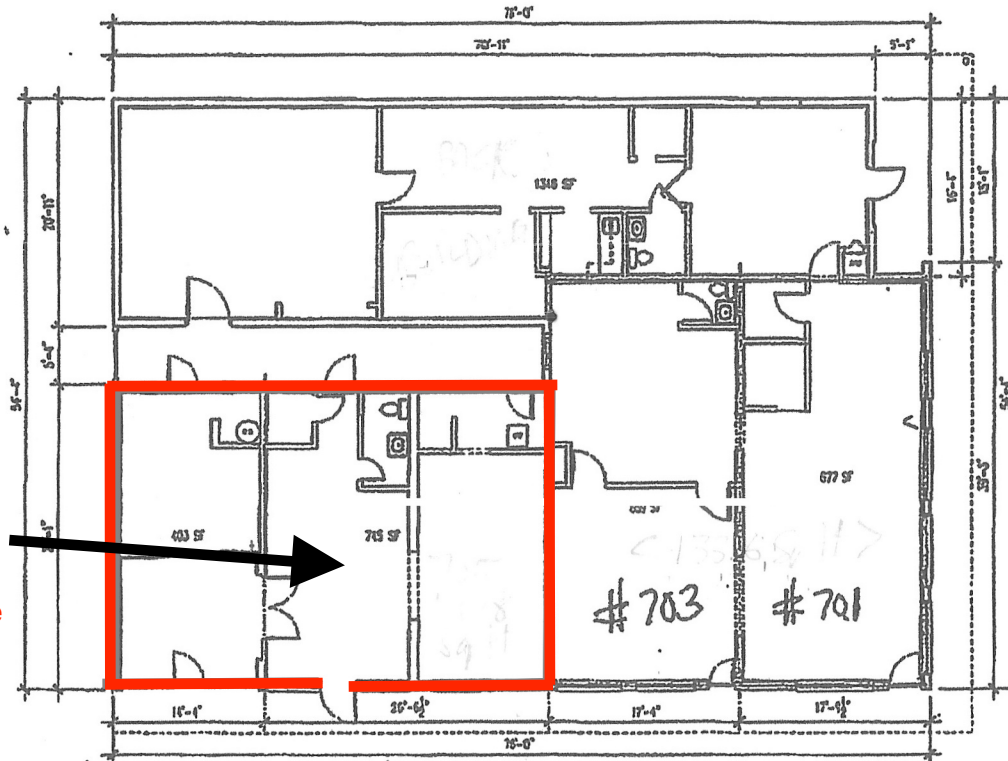

701 W. PLATT ST. - AS BUILT
SCALE 1/8" = 1'-0"